

**WALLACE LAKE DRIVE (SECTION 1)**  
DISTANCE - 0 TO GAS MAIN

STATION	DISTANCE
3+00	6.67'
4+00	7.00'
5+00	8.50'
6+00	9.00'
7+00	7.50'
8+00	8.00'
9+00	9.00'
10+00	9.33'
11+00	12.00'
12+00	12.00'
13+00	10.25'

**TEAL COURT**  
DISTANCE - 0 TO GAS MAIN

STATION	DISTANCE
1+00	12.5'
1+50	22.0' RT 13.0' LT
1+75	29.0' RT 23.25' LT
2+00	33.5' RT 27.5' LT

**WALLACE LAKE DRIVE (SECTION 2)**  
DISTANCE - 0 TO GAS MAIN

STATION	DISTANCE
1+00	16.33'
2+00	16.0'

**CHUCKATE COURT**  
DISTANCE - 0 TO GAS MAIN

STATION	DISTANCE
1+00	13.0'
2+00	12.0'
2+25	20.0'
2+50	32.0'
2+80	30.0' LT
2+82	24.0' RT

**WILLET COURT**  
DISTANCE - 0 TO GAS MAIN

STATION	DISTANCE
1+00	11.25'
2+00	11.00'
3+00	10.67'
4+00	11.00'
5+00	9.50'

**WALLACE LAKE DRIVE SOUTH**  
DISTANCE - 0 TO GAS MAIN

STATION	DISTANCE
1+00	5.0'
2+00	5.5'
3+00	5.5'
4+00	11.0'
5+00	11.5'
6+00	11.67'
7+00	12.0'
8+00	11.5'
9+00	11.5'
10+00	15.5'
11+00	16.33'

**60SHANK COURT**  
DISTANCE - 0 TO GAS MAIN

STATION	DISTANCE
1+00	5.25'
2+00	6.10'
3+00	6.00'
4+00	5.50'
4+80	35.00'


**NOTE:**  
ALL BEARINGS NOTED  
BASED ON COMPASS  
READING ONLY.

**NOTES:**

1. TRACER WIRE EXISTS THROUGHOUT ENTIRE SYSTEM.
2. ALL SERVICE LINES ARE 3/4" PLYETHYLENE.
3. ALL CENTERLINES NOTED ON PLANS REFER TO EXISTING PAINTED CENTERLINES ON ROADWAYS. CENTERLINE STATIONING BEGINS FROM CENTERLINE INTERSECTIONS.
4. THESE "AS-BUILT" DRAWINGS HAVE BEEN DEVELOPED FROM A COMPILATION OF THE FOLLOWING:
  - a) P.G. & E. "AS-BUILT" DRAWINGS
  - b) PACIFIC BELL "AS-BUILT" DRAWINGS
  - c) FIELD INSPECTOR DAILY REPORTS,
  - d) PHYSICAL IN FIELD VERIFICATION OF STEEL SERVICE RISER/VALVE LOCATIONS.
5. TRENCH LOCATIONS ARE APPROXIMATE ONLY AND SHOULD BE VERIFIED VIA TRACER WIRE PRIOR TO ANY EXCAVATION AS TO AVOID CONFLICTS. BEFORE DIGGING CONTACT THE FOLLOWING:
 

U.S.A. : 1-800-642-2444  
W.U.U.A. : 1-800-424-3447  
CAMPORA PROPANE SERVICE : 1-209-468-4088
6. LOCATION OF SERVICE RISERS SHOWN ON THIS PLAN ARE RELATIVE TO FRONT PROPERTY CORNERS.

**JOINT TRENCH CONFIGURATIONS-TYPICAL**  
N. T. S.

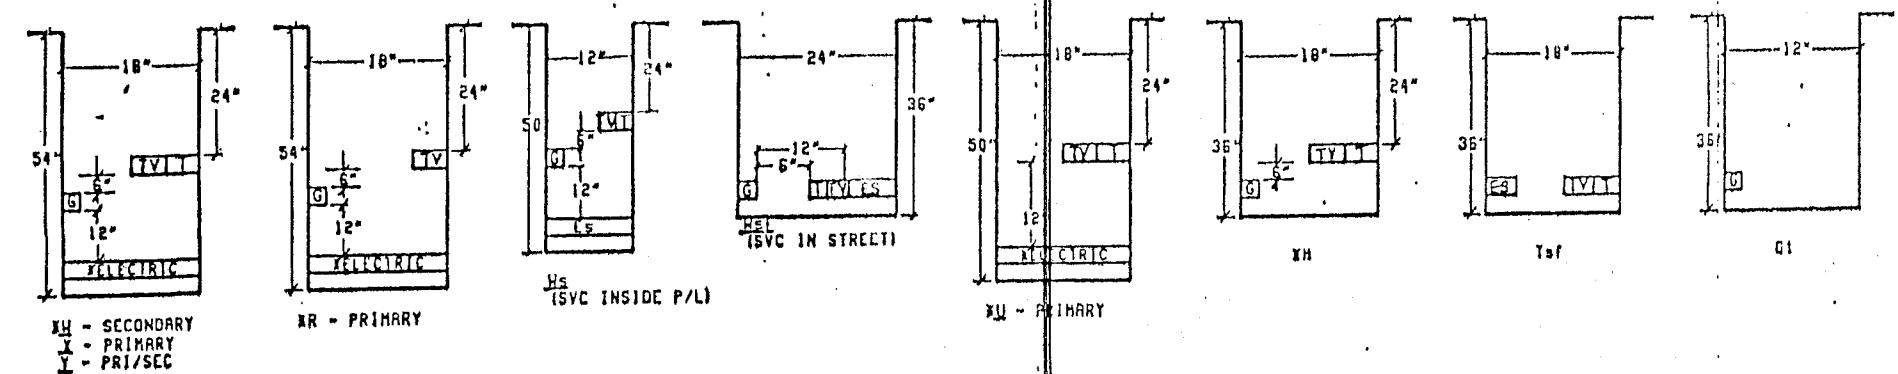

**LEGEND:**

- - - - - GAS MAIN LINE
- SERVICE RISER W/ VALVE.
- ④ GAS MAIN SIZE AS NOTED
- 4+60 : CENTERLINE STATION
- 15.0' : DISTANCE FROM SERVICE VALVE TO MAIN
- ..... EXISTING PAINTED CENTERLINES ON ROADWAY.

**GAS SYSTEMS ENGINEERING**  
DESIGN • CONSTRUCTION • MAINTENANCE

PROANE GAS SYSTEM  
DISTRIBUTION FACILITIES  
WALLACE ESTATES NO. 1

SHOWN BY	DATE
RC	7-11-90
CHECKED	NO. 0032
APPROVED	SCALE SHOWN
	NO. 0032

**WALLACE LAKE ESTATES**  
UNIT 1

**WEATHERBY REYNOLDS**  
CONSULTING ENGINEERS

206 PEEK ST., JACKSON, CA 95642 (209) 223-0381  
(209) 754-1137 FAX # (209) 223-0716

SCALE 1" = 100'

WALLACE LAKE DRIVE (SECTION 2)  
DISTANCE - CL TO GAS MAIN

STATION	DISTANCE
3+00	14.5'
4+00	12.0'
5+00	13.0'
6+00	12.5'
7+00	13.5'
8+00	13.25'
9+00	13.0'
10+00	12.0'

VERDIN COURT  
DISTANCE - CL TO GAS MAIN

STATION	DISTANCE
1+00	12.5'
1+55	12.5'
2+00	11.0'
2+45	22.0' RT
2+54	33.0' LT
2+74	23.0' RT

WALLACE LAKE DR. TO FUTURE  
DISTANCE - CL TO GAS MAIN





STATION	DISTANCE
1+00	16.0'
2+00	20.0'
3+00	13.5'
4+00	14.25'
4+87	14.25'

CORMORANT DRIVE  
DISTANCE - CL TO GAS MAIN

STATION	DISTANCE
1+00	12.5'
2+00	13.5'
3+00	12.0'
4+00	12.0'
5+00	12.0'
6+00	13.0'
7+00	11.0'
8+00	10.5'
9+00	12.5'
10+00	12.0'
10+65	14.5'
11+00	13.0'

TURNSTONE COURT  
DISTANCE - CL TO GAS MAIN

STATION	DISTANCE
1+00	15.0'
2+00	14.5'
3+00	14.5'
4+00	13.5'
5+00	11.5'
6+00	11.0'
7+00	10.5'
8+00	13.0'
8+25	14.0'
8+70	23.0'
8+84	33.0' LT, 32.0' RT
9+00	37.0' LT, 38.0' RT
9+20	33.0' LT
9+34	25.0' RT

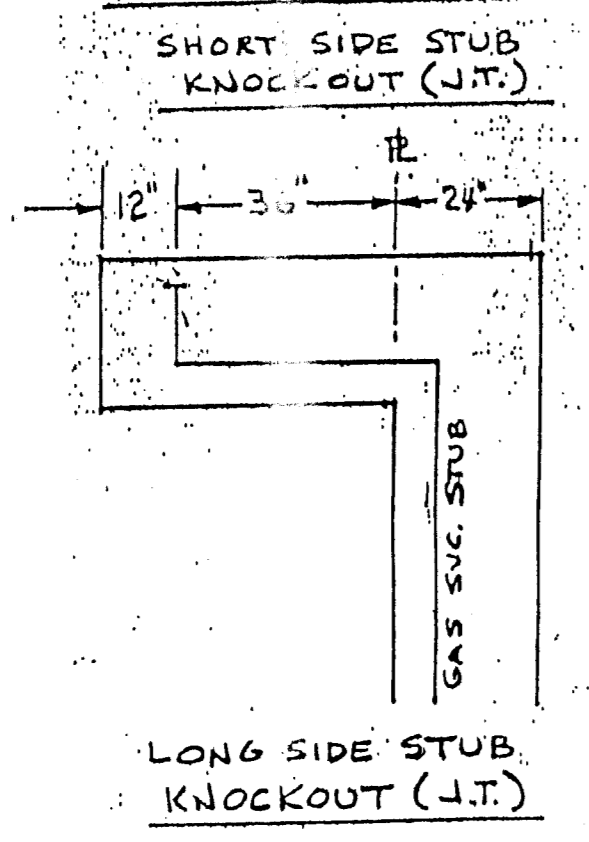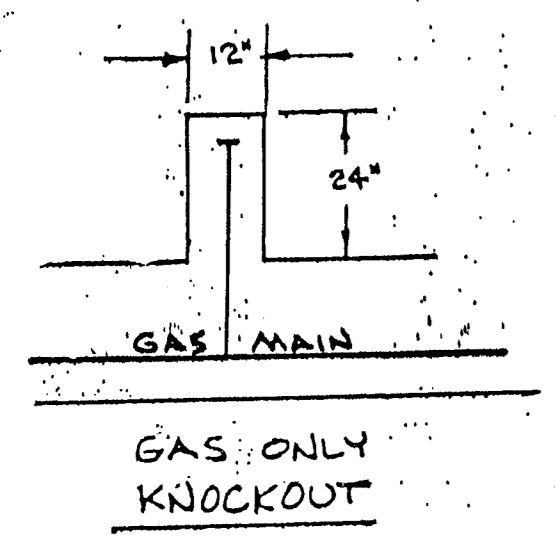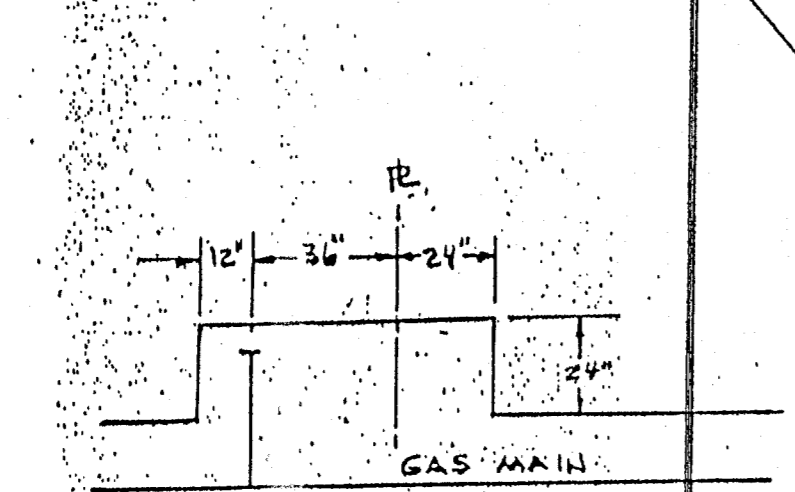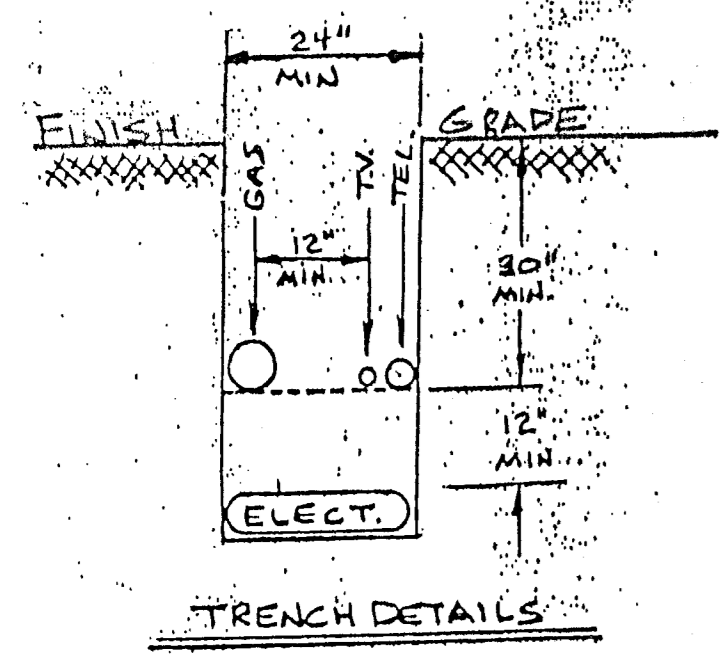

- NOTES:
- 1) SAND REQUIREMENTS: 4" UNDER & 6" OVER ALL GAS FACILITIES.
  - 2) ALL GAS STUB SERVICES SHALL BE 3/4" IPS (POLYETHYLENE)
  - 3) ALL WORK TO BE IN ACCORDANCE WITH P.G.E. STANDARDS AND SPEC'S.
  - 4) CONTRACTOR TO INSTALL CONDUIT XINGS ON MAIN & STUB SIG XINGS.
  - 5) CONTRACTOR TO COORDINATE ALL TRENCHING & INSTALLATION WITH P.G.E. REPRESENTATIVE.
  - 6) SEE "SPECIFIC CONDITIONS FOR GAS MAIN & SERVICE INSTALLATION WORK", FOR MATERIALS & VENDORS APPROVED LISTS.

LEGEND:

- : GAS MAIN LINE
- : SERVICE RISER W/ VALVE
- 4" : GAS MAIN - SIZE AS NOTED
- 4+60 : CENTERLINE STATION
- 15.0' : DISTANCE FROM SERVICE VALVE TO MAIN
- : EXISTING PAINTED CENTERLINES ON ROADWAY

GAS SYSTEMS ENGINEERING  
DESIGN • CONTRACTING • MAINTENANCE

20801 28215 CARMENITA CA 95642 (209) 223-0381

PROANE GAS SYSTEM DISTRIBUTION FACILITIES  
WALLACE ESTATES NO. 1

PROJECT NO. 7-11-90  
CHECKED: 06/06/00  
APPROVED: SCALE SHOWN: DWG NO. 0032-  
DATE: 02/23/00

WALLACE LAKE ESTATES  
UNIT 1

**WEATHERBY REYNOLDS**  
CONSULTING ENGINEERS

208 PECK ST., JACKSON, CA 95642 (209) 223-0381  
(209) 754-1137 FAX # (209) 223-0716